HVAC NOTES

1. WALL AND ROOF THERMAL AIR INFILTRATION.
   - A. CEILING AREAS ABOVE CUSTOMER SERVICE, OFFICE AND SHOWROOM AREAS WITH 6" FIBERGLASS BATTS FOR A-19.
   - B. EXTERIOR WALLS TO BE BLDG. STD.
   - C. ROOF TO BE BLDG. STD.
   - D. SPRINKLER SYSTEM TO ACCOMMODATE CLAY TILE, GENERALLY RATED AS CLASS 2 COMMODITY, IN BOXES ON PALLETS. A HEIGHT AND CONFIGURATION AS SHOWN ON THESE DRAWINGS IF REQUIRED BY CODE.
2. OFFICE AND SHOWROOM AREA TO BE HEATED AND AIR CONDITIONED HEATING IN WAREHOUSE TO BE OMITTED IN AREAS OF THE COUNTRY WHERE YEAR ROUND OUTDOOR TEMPERATURES PRECLUDE NEED FOR HEATING SYSTEMS. THE SYSTEM IS TO BE DESIGNED AS FOLLOWS:
   - A. HEATING - INSIDE DRY BULB TEMPERATURE 70°F. OUTSIDE DRY BULB TEMPERATURE 0°F.
   - B. COOLING - INSIDE 75°F (EFFECTIVE TEMP.), AS DEFINED BY ASHRAE COMFORT STD. 55-56. OUTSIDE 93°F. DRY BULB, 77°F. W.B.T.
   - C. WAREHOUSE HEATING - DESIGNED TO MAINTAIN INSIDE DRY WET BULB TEMPERATURE 55°F. OUTSIDE DRY BULB 11°F. WET BULB 8°F. (OMITTED IN AREAS WHERE YEAR ROUND OUTDOOR TEMPERATURES PRECLUDE NEED FOR HEATING SYSTEM.)

PLUMBING FIXTURE NOTES


1. WATER HEATER: PROVIDE 18 GALLON BRADFORD WHITE LIGHT DUTY LOW BOY OR EQUAL AS SHOWN ON PLANS.
2. RESTROOM FIXTURES UNLESS NOTED OTHERWISE
   - A. LAVATORIES - AMERICAN STANDARD "LUCERNE" WALL MOUNTED
   - B. FAUCETS - AMERICAN STANDARD "EVA" #4902.110 SINGLE LEVER CONTROL DRAIN ASSEMBLY, SUPPLIED WITH STOPS AND DRAIN FITTINGS. ALL EXPOSED PIPING TO HAVE INSULATED COVERING IN COLOR WHITE.
   - C. TOILETS TO BE BUILDING STANDARD, COLOR WHITE, WITH CHROME GRAB BARS. ALL HANDICAPPED ACCESSIBLE IN ACCORDANCE WITH ADA ACT OF 1990 REQUIREMENTS.
4. UTILITY SINK: TO BE EQUAL TO OR FIAT #1153-2424, E-TIAA RIM GUARD. AMERICAN STANDARD FAUCET #8340-234 "EXPOSED YOLK SINK, MOUNT UTILITY FAUCET".
5. ACCESSORIES: RESTROOMS TO HAVE CHROME TOILET PAPER HOLDERS, CHROME C-FOLD TOWEL DISPENSERS, AND CHROME SOAP DISPENSER. MIRRORS TO BE INSTALLED 40 INCHES MAX. TO BOTTOM OF MIRROR. ALL IN ACCORDANCE WITH AMERICAN'S WITH DISABILITIES ACT OF 1990.

CONSTRUCTION KEYNOTES

1. PROVIDE & INSTALL 8'-0" W X 4'-0" H X 3/4" FIRE TREATED WALL MOUNTED PLYWD BOARD FOR TELEPHONE EQUIPMENT, RE: A8. PAINT TO MATCH ADJACENT WALLS. ALL CONDUIT FOR VOICE/DATA TO HAVE PULL WIRES.
2. REFER TO ENLARGED RESTROOM PLAN/A9.
3. PROVIDE AND INSTALL NEW 18 GAL. ELEC. WATER HEATER WITH ALL NEW PLUMBING REQUIREMENTS ABV. CEILING. RE: PLUMBING FIXTURE NOTE 1
4. INSTALL 4'-0" X 3'-0" INTERIOR WINDOW, RE: A7.
5. PERIMETER OF SHOWROOM AND OFFICE AREA TO HAVE 1X6 WOODEN BASE TO PROTECT WALLS. (ON WAREHOUSE SIDE OF PARTITIONS.) PAINT TO MATCH WALLS
6. PAINT PERIMETER OF WAREHOUSE SIDE OF OFFICE AREA/WAREHOUSE DEMISING WALL. REFER FINISH SCHEDULE A7.
7. EXISTING UTILITY SINK.
8. NEW WALLS IN SHOWROOM TO RECEIVE CONTINUOUS 20 GAUGE SHEET METAL BEHIND 5/8" GYP. BD. FOR WALL DISPLAY SUPPORT - REFER A8
9. CABINETS AND COUNTERS BY DATILE.
10. REFRIGERATOR BY DALTILE
11. NEW CONC. SIDEWALK TO NEW ENTRANCE. FIELD VERIFY DIMENSIONS INSTALL NEW EDGE AT LANDSCAPE PLANTER
12. FILL EXISTING OPENING
13. WALL DISPLAY SUPPORT ON EXISTING WALLS: INSTALL ONE LAYER 5/8" GYP. BD OVER ONE LAYER 20 GAUGE SHEET METAL, SECURE TO EXISTING WALL. TAPE, BED AND PAINT, APPLY CORNER BEAD ON ALL EDGES. REFER SHEET A8 FOR LOCATIONS

GRAPHIC SYMBOLS STANDARD : ALL MAY NOT BE USED.

- XXXX / 101 — ROOM NAME & NUMBER
- XXX — NEW DOOR NUMBER
- E — DENOTES EXISTING DOOR TO REMAIN
- X — WALL TYPE ALL WALLS TO BE TYPE 1 UNLESS NOTED OTHERWISE
- XXXX — ELEVATION
- XXXX — SECTION
- 1 — REVISION REFERENCE
- EXISTING WALLS TO REMAIN
- NEW PARTITIONS
- DEMOLITION

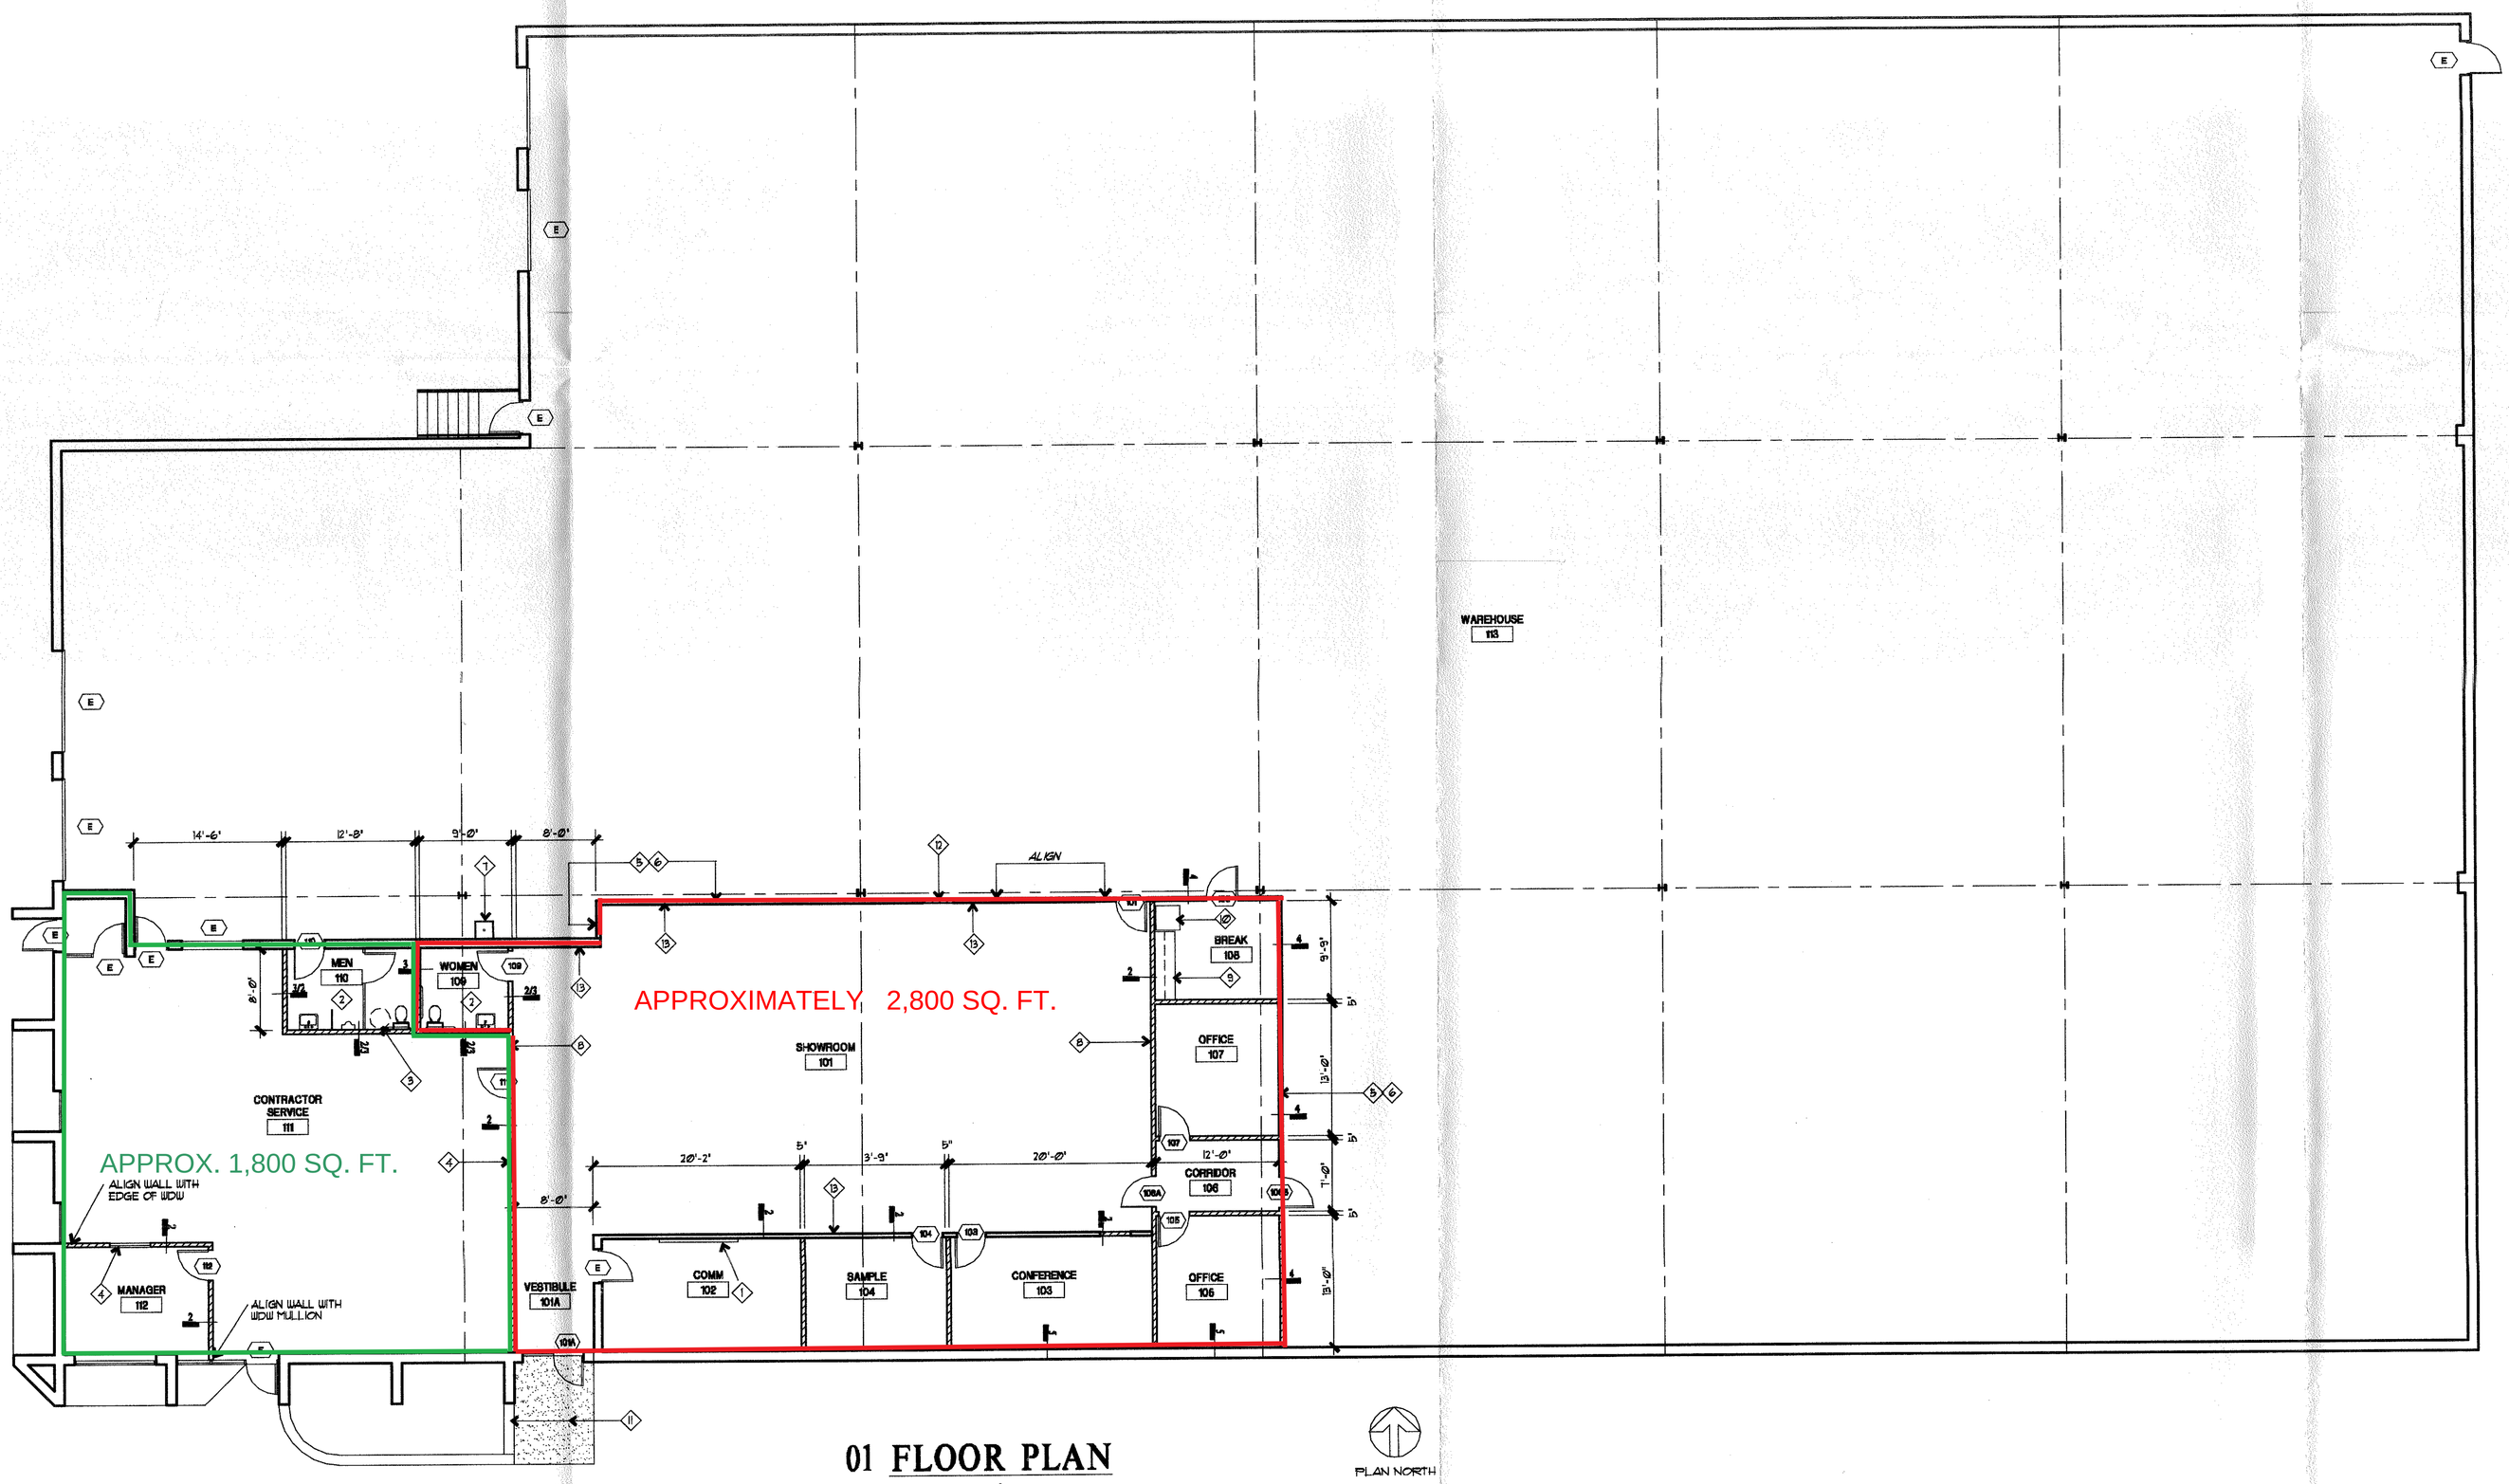

01 FLOOR PLAN
1/8" = 1'-0"

PLAN NORTH

daltile

7834 C F HAWN FREEWAY
DALLAS, TX 75217
www.daltile.com

SALES SERVICE CENTER #064
5105 CAMPUS DRIVE
WHITEMARSH TOWNSHIP, PA 19462

ISSUE LOG

DESCRIPTION	DATE
FOR REVIEW	07.26.06
FOR CONSTRUCTION	09.15.06
REVISION 1	02.19.07

Dennis T Mitchell NCARB, AIA
Architect
6631 I-20 WEST, SUITE 260
ARLINGTON, TX 76017
817-483-1146 FAX 817-483-7377
mitchellarchitects@sbcglobal.net

JOB #: 064-0706
DATE: 07.26.06
SCALE: 1/8" = 1'-0"

SHEET NO.
A2